A	TEMP DRAWING	DRAWN	05-27-05
		APPD.	DATE

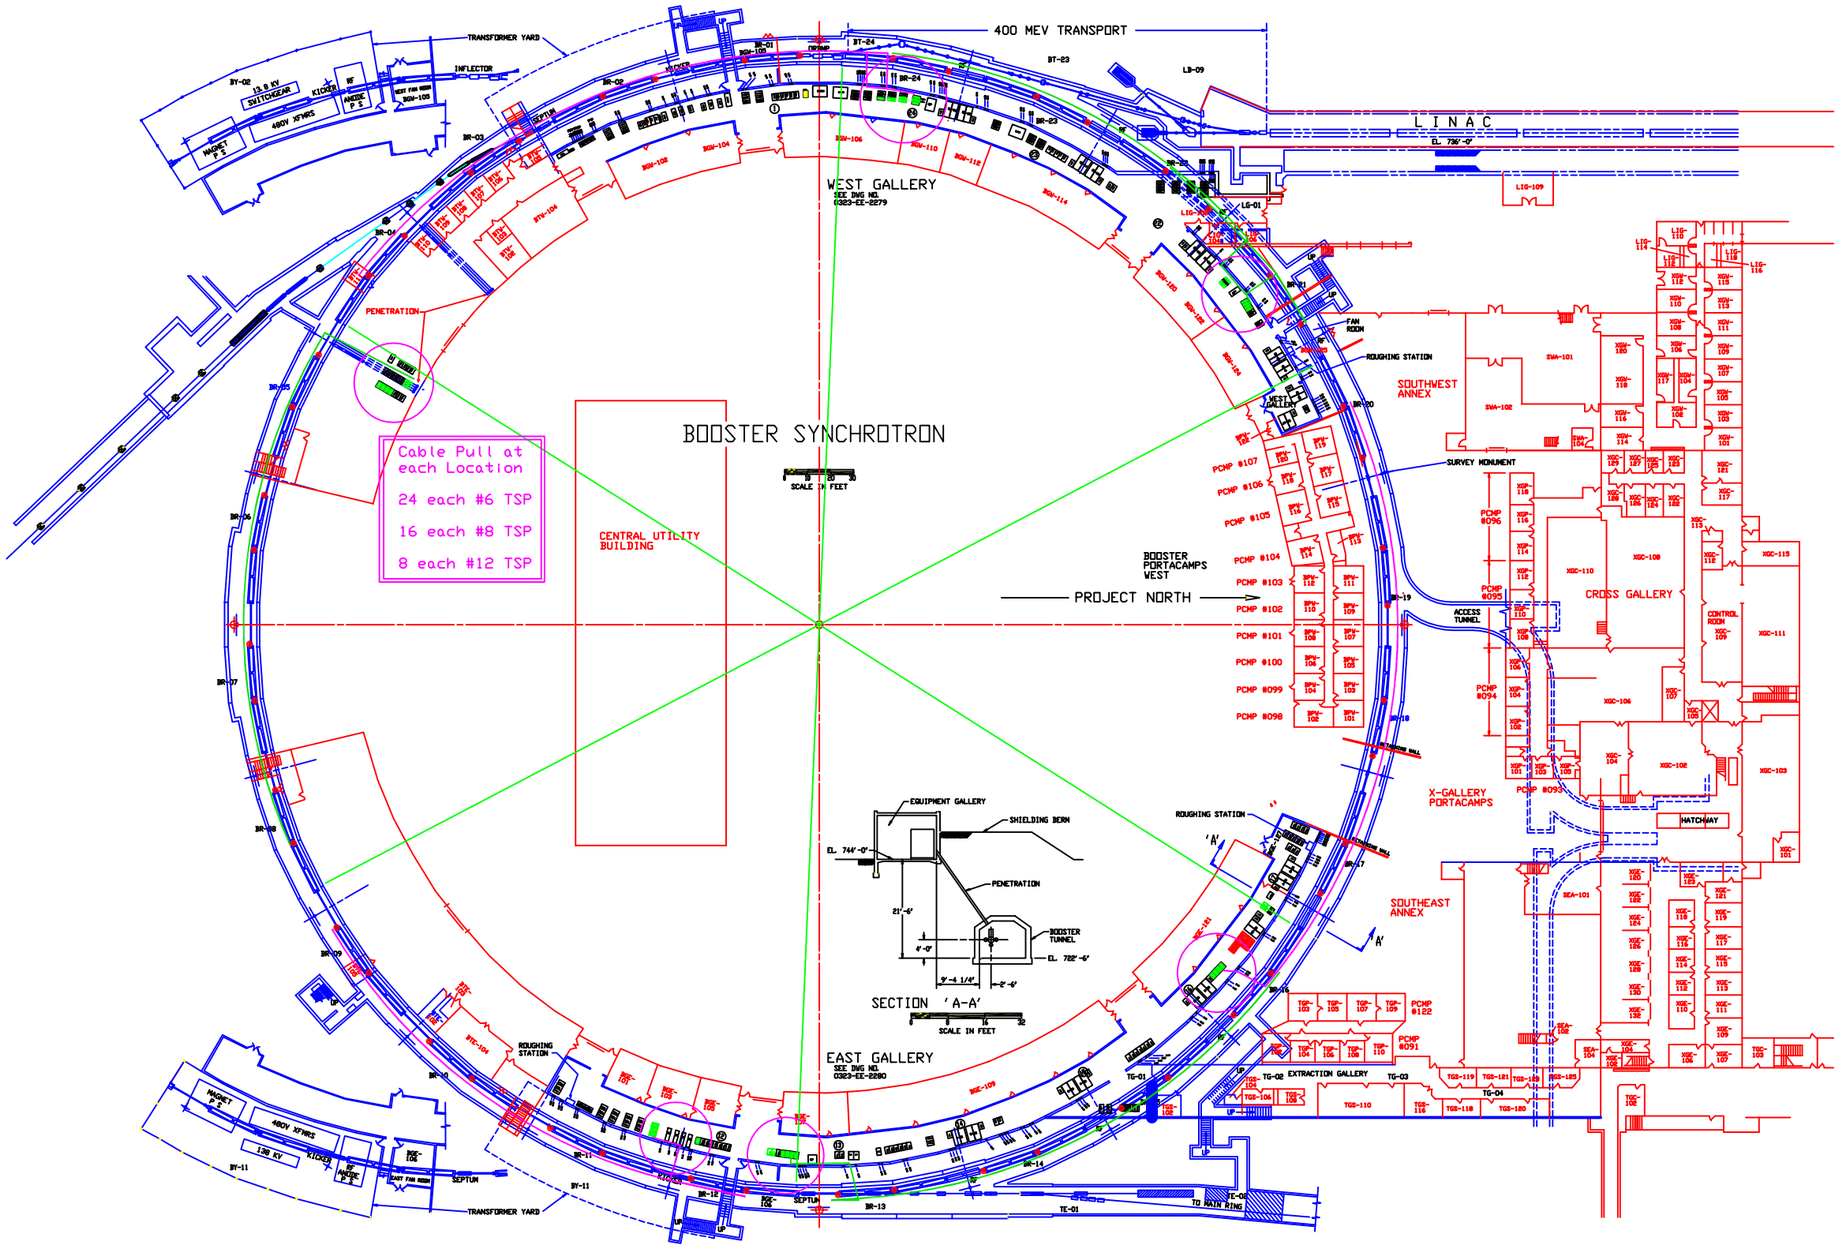

TOLERANCES UNLESS OTHERWISE SPECIFIED			ORIGINATOR 1-95 J. LACKEY
FRACTIONS ±	DECIMALS ±	ANGLES ±	DRAWN 05-27-05 R MEADOWCROFT
DIMENSIONS AND TOLERANCES PER ANSI Y14.5 STANDARDS.			CHECKED
BREAK SHARP EDGES 1/64 MAX. DO NOT SCALE DRAWING.			APPROVED
USED ON			MATERIAL
			CADFILE: [BOOST_299]299933

ITEM NO.	PART NUMBER	DESCRIPTION OR SIZE	QTY.

FERMI NATIONAL ACCELERATOR LABORATORY
UNITED STATES DEPARTMENT OF ENERGY

BOOSTER SYNCHROTRON
MAJOR COMPONENT I.D. W/NEW 8 GEV PLAN
AND FOOTPRINT AREA COMPOSITE

SCALE	FILMED	DRAWING NUMBER	REV
.048" = 1'-0"		0300.000-ME-299933	

CREATED WITH I-DEAS_V. | USER NAME: CRAYTON

FRONT